


SCALE 1" = 100'

HICKORY CREEK BLVD

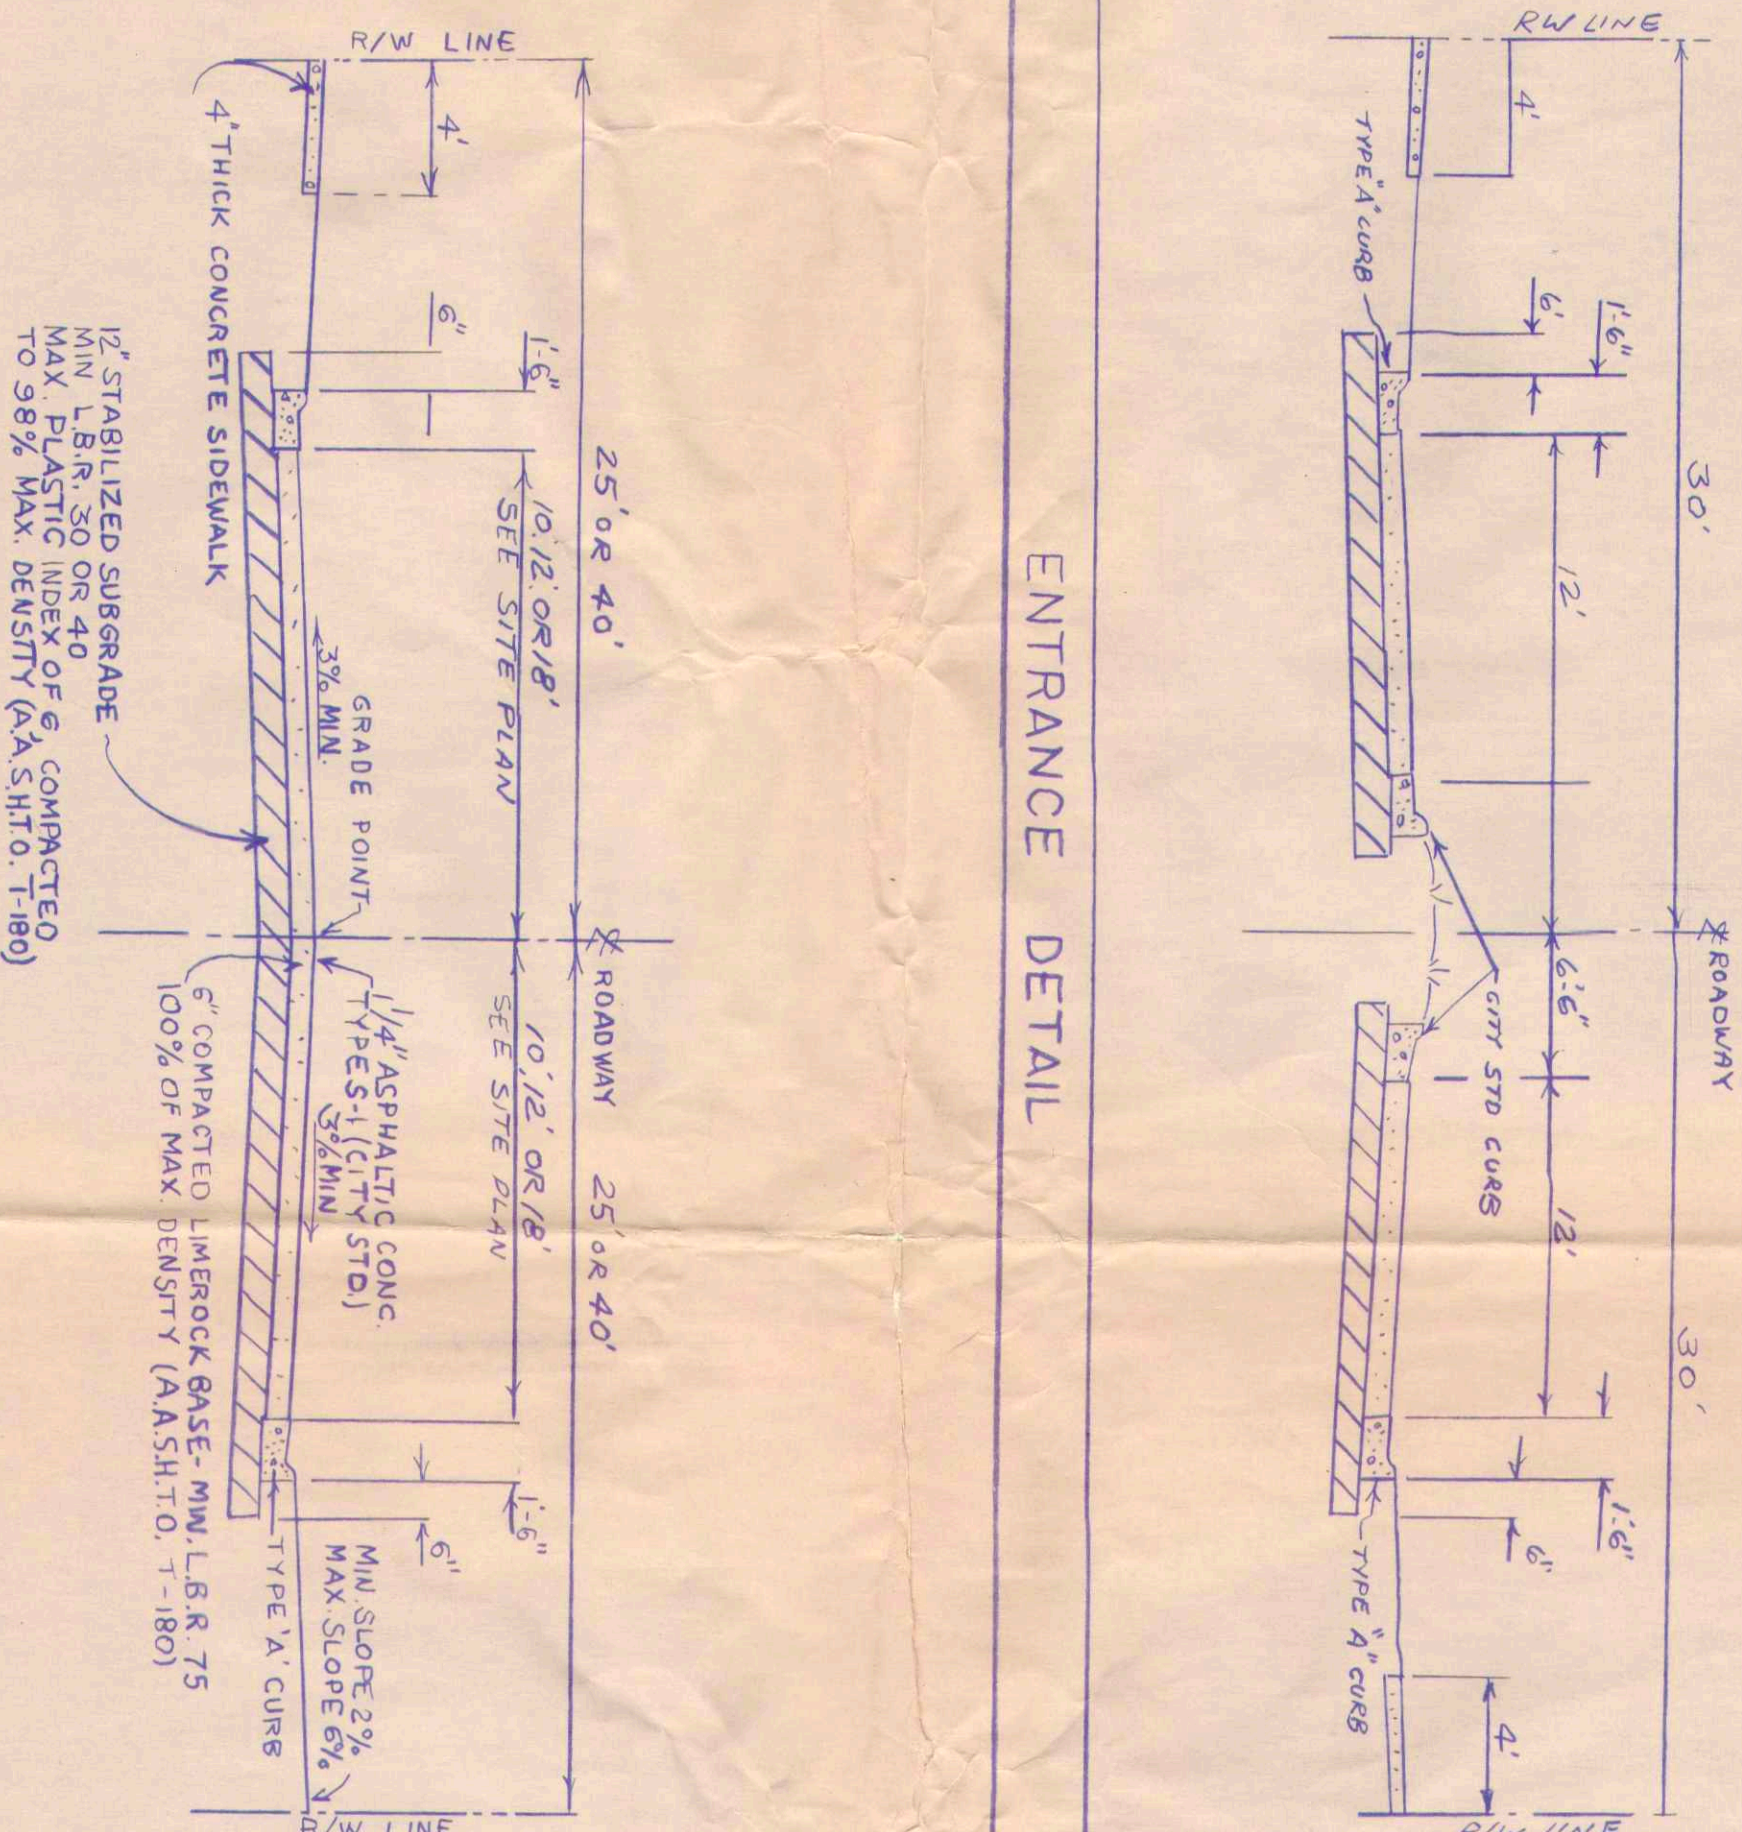

ENTRANCE DETAIL

TYPICAL ROADWAY SECTION

SURVEYORS STATEMENT
I HEREBY CERTIFY THAT THE
HORIZONTAL AND VERTICAL
LOCATIONS OF THE UTILITIES
WERE FIELD VERIFIED AND
REFLECT THE ACTUAL CONDITIONS
SHOWN ON THIS AS-BUILT
DRAWING.

BY: W. A. JOHNS
WITH: W. A. JOHNS
DATE: 22 SEP 87
FLORIDA REGISTRATION NO. 2757


CONTRACTOR STATEMENT
I CERTIFY THAT I HAVE THOROUGHLY STUDIED
THIS DRAWING AND IT IS CORRECT
AND SHOWS EXACTLY WHAT WAS INSTALLED.

BY: W. A. JOHNS
WITH: W. A. JOHNS
DATE: 9-7-89

STRUCTURE NO.	TYPE	GRATE ELEV.	SLOT ELEV.	FLOW LINE ELEV.
E 21 M	INTERIOR	—	—	21.25 N
E 22 M	INTERIOR	—	—	21.25 W
E 27 S	INTERIOR	—	—	17.29 S


STRUCTURE NO.	TYPE	GRATE ELEV.	SLOT ELEV.	FLOW LINE ELEV.	STRUCTURE NO.	TYPE	GRATE ELEV.	SLOT ELEV.	FLOW LINE ELEV.
E 7	INTERIOR	—	—	21.00 N	S 59	A INLET	26.00	—	21.17 E
E 19	A INLET	27.25	—	21.91 S	S 60	A INLET	24.00	—	21.03 E
E 23	INTERIOR	—	—	21.23 W	S 61	C INLET	23.76	21.64	19.30 N
E 24	INTERIOR	—	—	21.00 W	S 62	C INLET	23.76	21.64	19.30 N
E 25	INTERIOR	—	—	20.50 S	S 63	A INLET	24.35	—	21.85 E
E 29	INTERIOR	—	—	16.80 S	S 64	A INLET	24.35	—	21.85 E
E 29	INTERIOR	—	—	18.40 N	S 65	C INLET	24.70	21.61	16.94 N
E 30	INTERIOR	—	—	25.25 S	S 66	A INLET	23.65	—	21.42 S
E 31	INTERIOR	—	—	25.00 N	S 67	A INLET	23.65	—	21.42 S
S 51	A INLET	24.65	—	21.86 E	S 68	A INLET	24.65	—	21.70 E
S 52	A INLET	27.00	—	24.65 E	S 69	A INLET	24.40	—	21.52 W
S 53	A INLET	26.10	—	23.78 E	S 70	A INLET	24.65	—	21.70 E
S 54	A INLET	25.25	—	23.09 E	S 71	A INLET	24.65	—	21.70 E
S 55	A INLET	25.70	—	23.44 E	S 72	A INLET	24.65	—	21.70 E
S 56	C INLET	24.20	22.01	21.44 N	S 73	A INLET	24.65	—	21.70 E
S 57	A INLET	24.30	22.01	20.54 S	S 74	A INLET	24.65	—	21.70 E
S 58	A INLET	24.30	22.01	20.54 S	S 75	A INLET	24.65	—	21.70 E

SEE ACTUAL ELEVATIONS ABOVE
PLAN "ELEVATIONS"

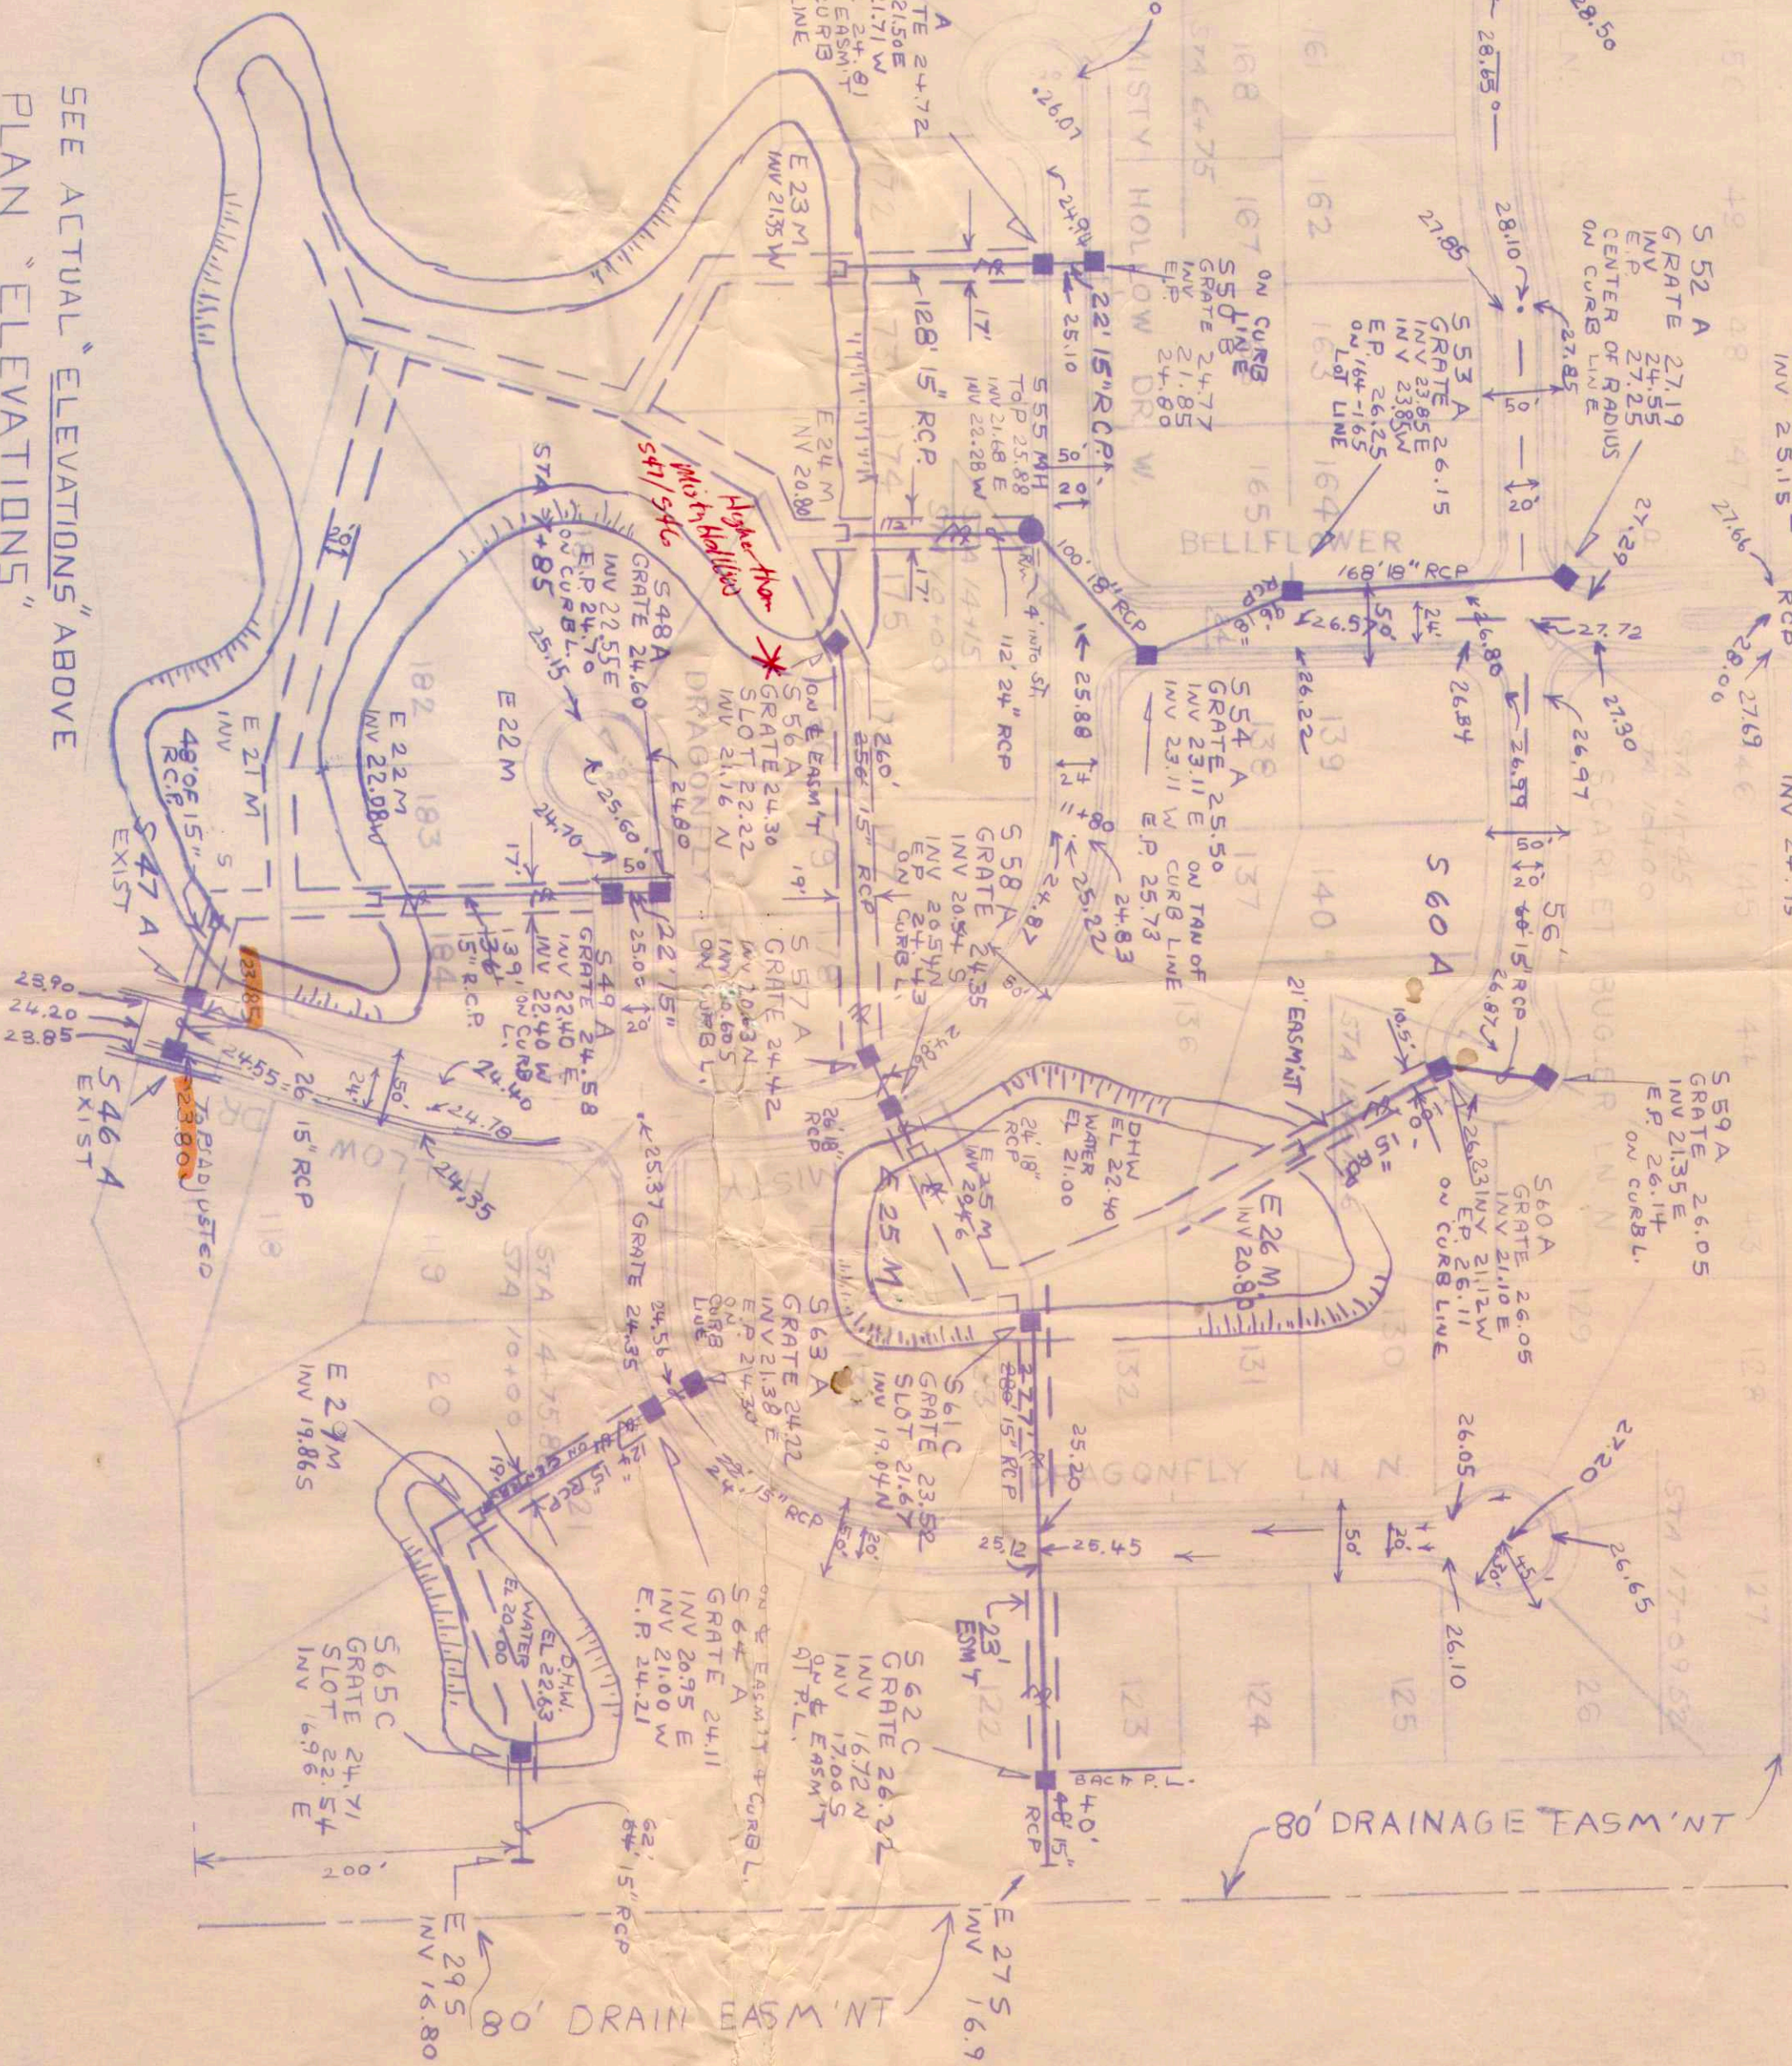

AS-BUILT

HICKORY CREEK IV

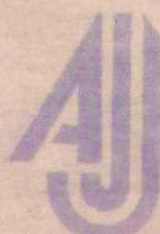

A. J. JOHNS
CONTRACTOR

BY

PAVING +
DRAINAGE LOTS 4, 5, 6