


NO OBJECTION
PLANNING AND DEVELOPMENT
DIVISION

22004

1" = 20'

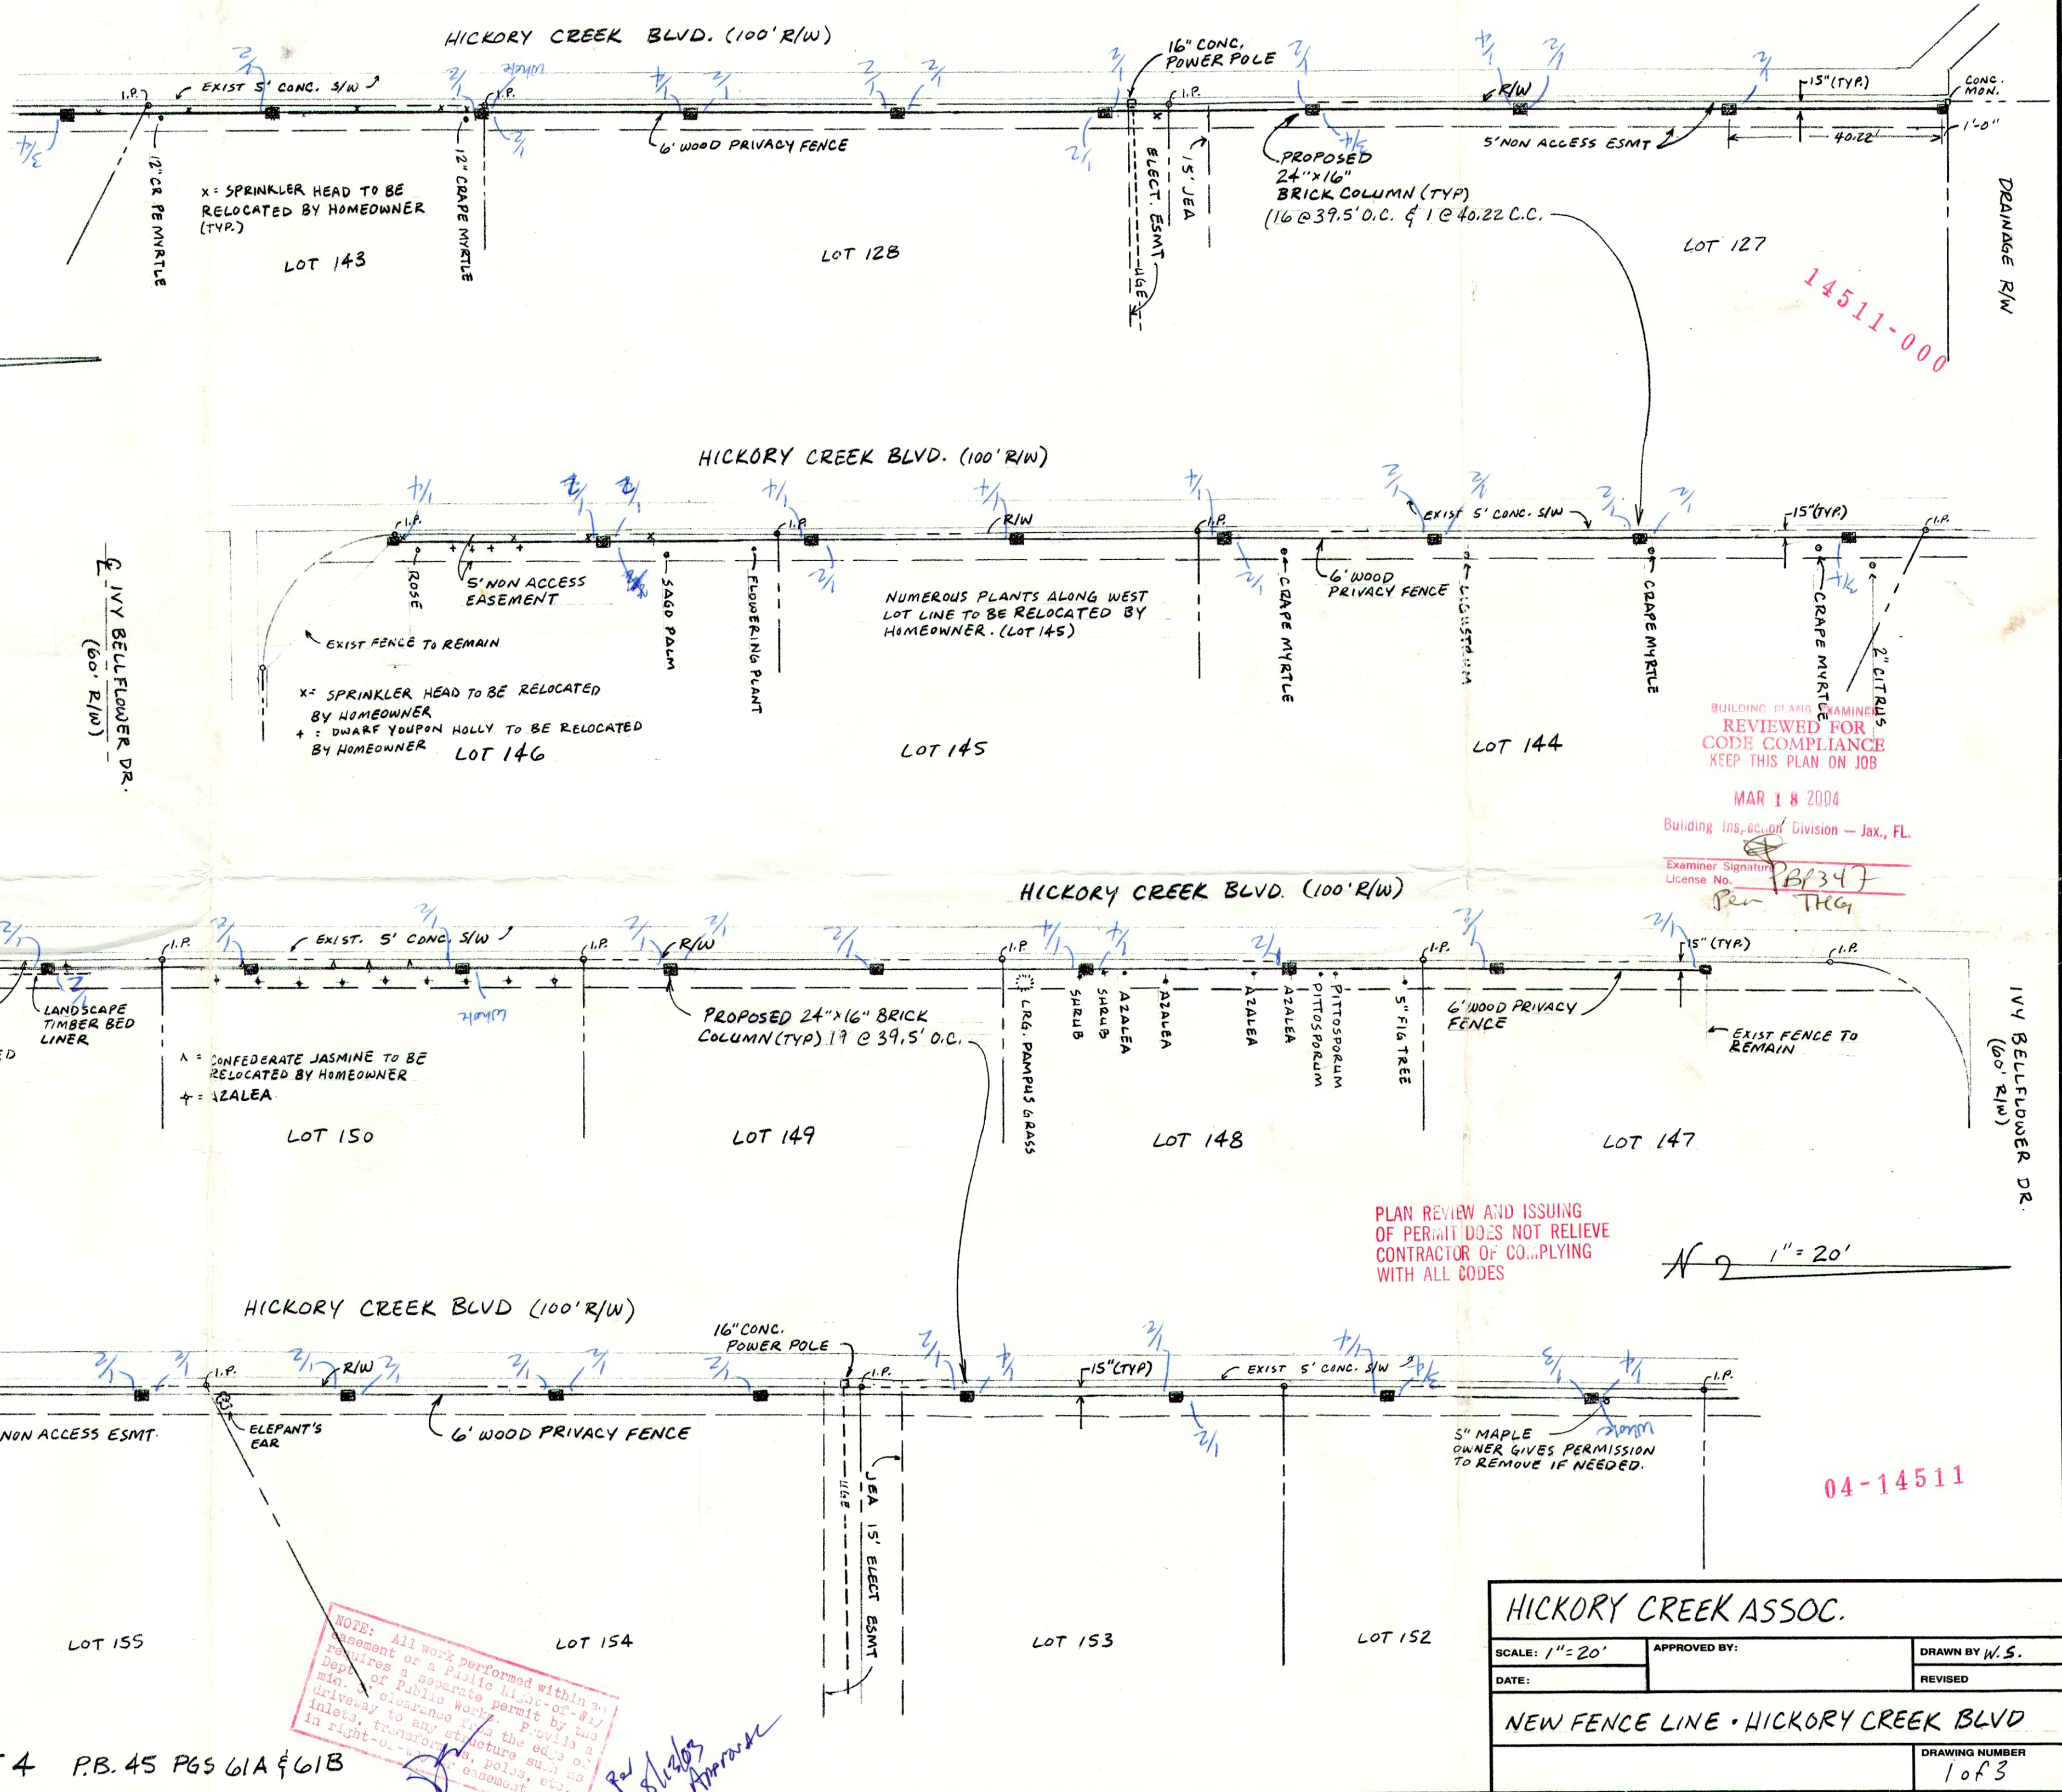

BUILDING PLANS EXAMINED
REVIEWED FOR
CODE COMPLIANCE
KEEP THIS PLAN ON JOB

MAR 18 2004

Building Ins. & Code Division - Jax., FL.

Examiner Signature
License No. B1347
Per THG

PLAN REVIEW AND ISSUING
OF PERMITS DOES NOT RELIEVE
CONTRACTOR OF COMPLYING
WITH ALL CODES

1" = 20'

04-14511

HICKORY CREEK ASSOC.

SCALE: 1" = 20' APPROVED BY: DRAWN BY W.S.

DATE: REVISED

NEW FENCE LINE - HICKORY CREEK BLVD
DRAWING NUMBER
1 of 3

HICKORY CREEK UNIT 4 P.B. 45 PGS 61A & 61B

NOTE: All work performed within an easement or a public right-of-way requires a separate permit by the Dept. of Public Works. Provide a minimum clearance of 10' from the edge of driveway to any structure such as inlets, transformers, poles, etc. in right-of-way easement.

Red Slabs Approved