

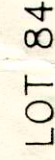


LOT 85

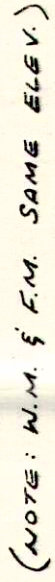

10 5 0 10 20 30
SCALE IN FEET

SEE HICKORY CH.
ADDITION WATER &
SEWER ASBUILTS DWG. W-1
FOR CONTINUATION.

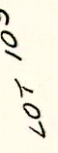

F.M. & W.M. CROSSING
SECTION "A-A"

1. THE CONTRACTOR SHALL BE RESPONSIBLE FOR DETERMINING THE EXACT LOCATION OF ALL EXISTING UTILITIES AND FOR DAMAGE TO EXISTING UTILITIES CAUSED BY HIS OPERATION.

2. THE CONTRACTOR SHALL VISIT THE JOB SITE PRIOR TO BIDDING TO FAMILIARIZE HIMSELF WITH JOB SITE CONDITIONS.

3. ALL FORCE MAINS AND WATER MAINS SHALL HAVE A MINIMUM OF 30" COVER OVER THE TOP OF THE PIPE IN UNPAVED AREAS AND A MINIMUM OF 36" IN PAVED AREAS UNLESS OTHERWISE SHOWN.

4. THERE MUST BE A TEN FOOT HORIZONTAL SEPARATION BETWEEN WATER AND SEWER LINES AND AN 18 - INCH VERTICAL SEPARATION WHERE POSSIBLE. IF 18 INCHES IS NOT POSSIBLE, THE FORCE MAIN MUST BE CONCRETE ENCASED EXTENDING TO FEET EACH SIDE OF CROSSING AS REQUIRED UNDER F.A.C 17-6.

5. CONTRACTOR SHALL ARRANGE FOR AND PAY FOR ALL TESTING AS REQUIRED BY THE CITY OF JACKSONVILLE SPECIFICATIONS PERTAINING TO THIS JOB.

6. THE CONTRACTOR SHALL FILE WITH THE ENGINEER FOR USE IN PRESENTATION OF "AS-BUILT" DWGS. ONE SET OF PLANS CLEARLY INDICATING LOCATIONS, INFORMATION AND DEVIATIONS FROM THE ORIGINAL PLANS. REPRODUCIBLE MYLAR "AS BUILT" DWGS. MUST BE FURNISHED TO THE CITY FOR REVIEW AND APPROVAL.

7. CONTRACTOR SHALL CONTACT CITY OF JACKSONVILLE 24 HOURS IN ADVANCE PRIOR TO WORKING ON THE CITY SYSTEM.


8. SHOP DRAWINGS ARE REQUIRED AND MUST BE APPROVED BY THE CITY BEFORE CONSTRUCTION.

9. COORDINATION OF THE WATER SERVICE AND GRAVITY AND FORCE MAIN ALONG MEADOWSWEET LANE SHALL BE AS SHOWN ON THE PLANS AS DESIGNED BY WILLIAM HOOD AND ASSOCIATES, INC.

10. ALL FENCING SHALL BE IN ACCORDANCE WITH CITY STANDARDS.

11. DRIVEWAY CONSTRUCTION SHALL BE CONCRETE PER CITY STANDARDS.

12. ALL INSPECTIONS SHALL BE COORDINATED WITH THE CITY.

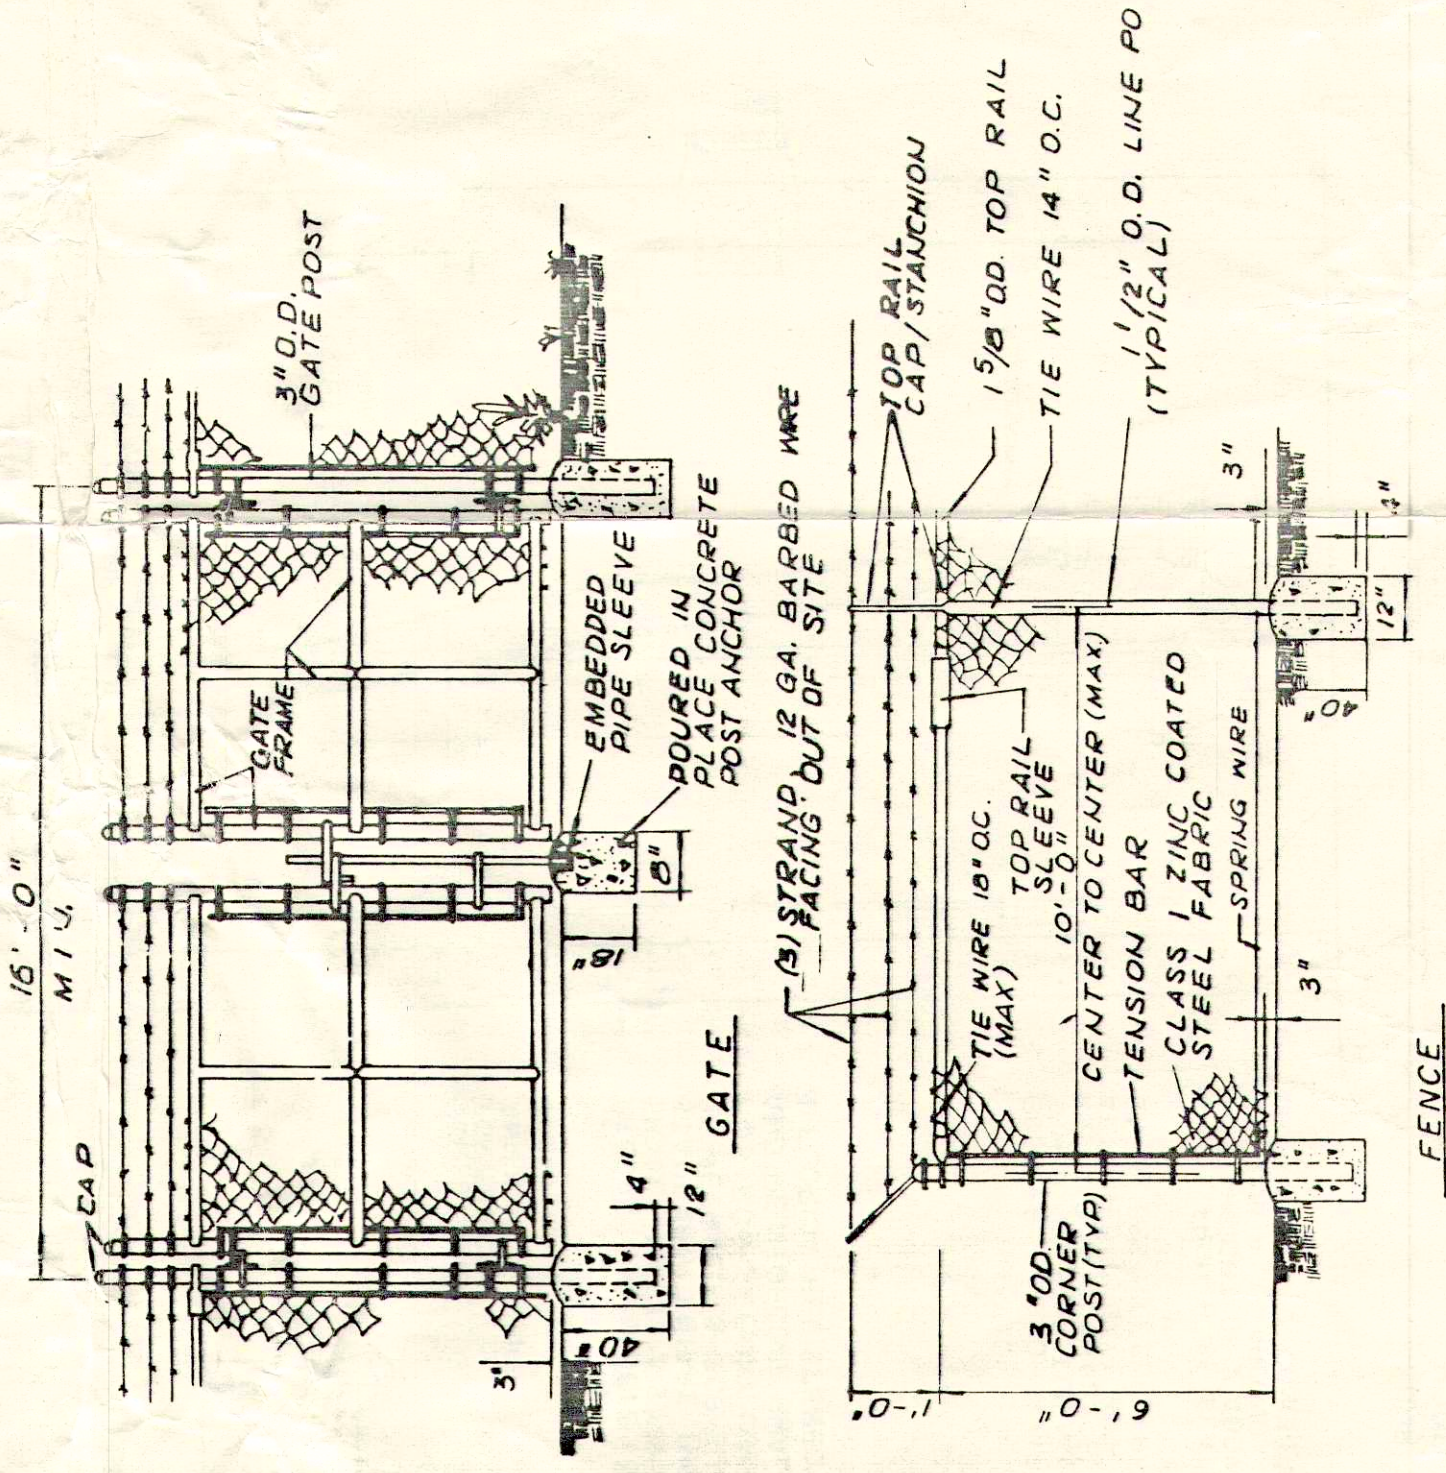

TYPICAL GATE & FENCE DETAIL

N.T.S.

APPROVED

DATE 3-22-88

WATER SERVICES DIVISION
PLANNING & ENGINEERING

ALL AMERICAN SURVEYORS, INC.

AS-BUILT

LIFT STA. SITE LAYOUT

DATE: 3/16/80

TH: D. W. HATSON CO., INC.

A-S-BUILT