



VICINITY MAP

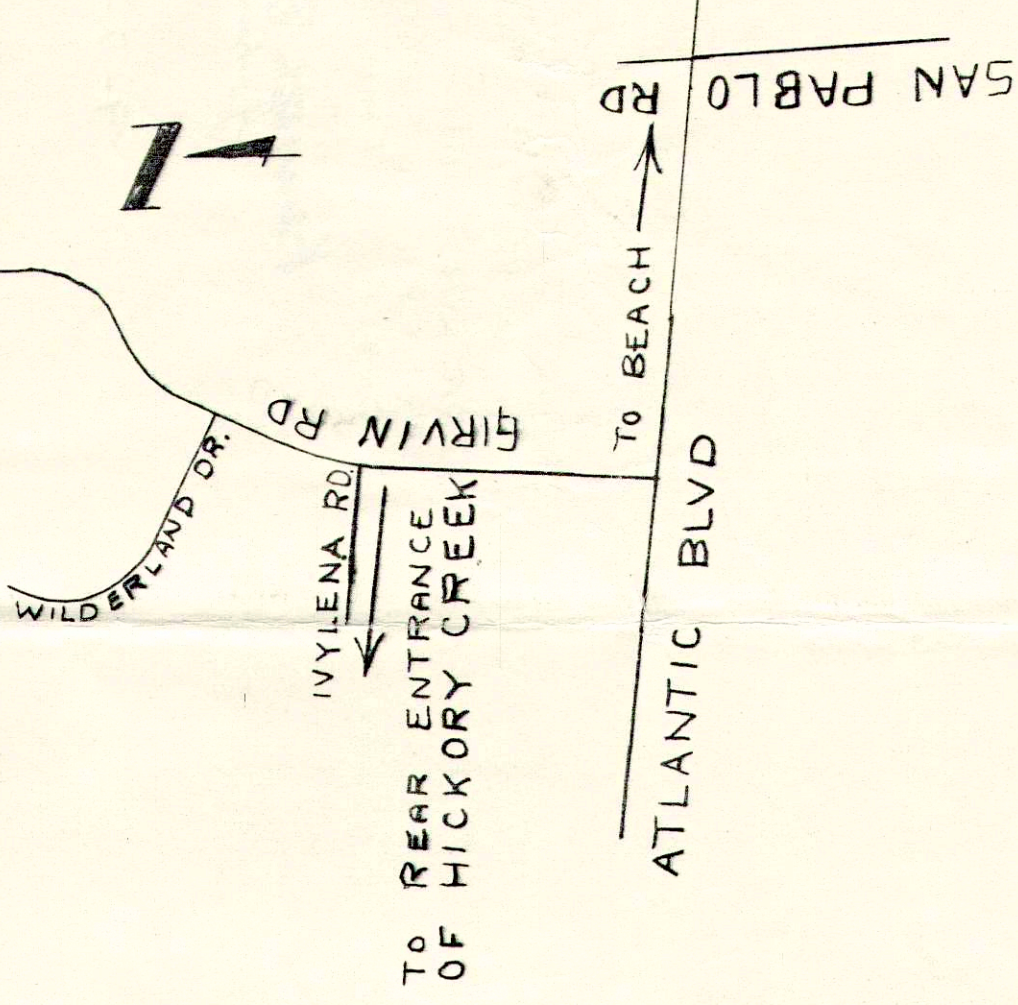

SCALE 1" = 100'

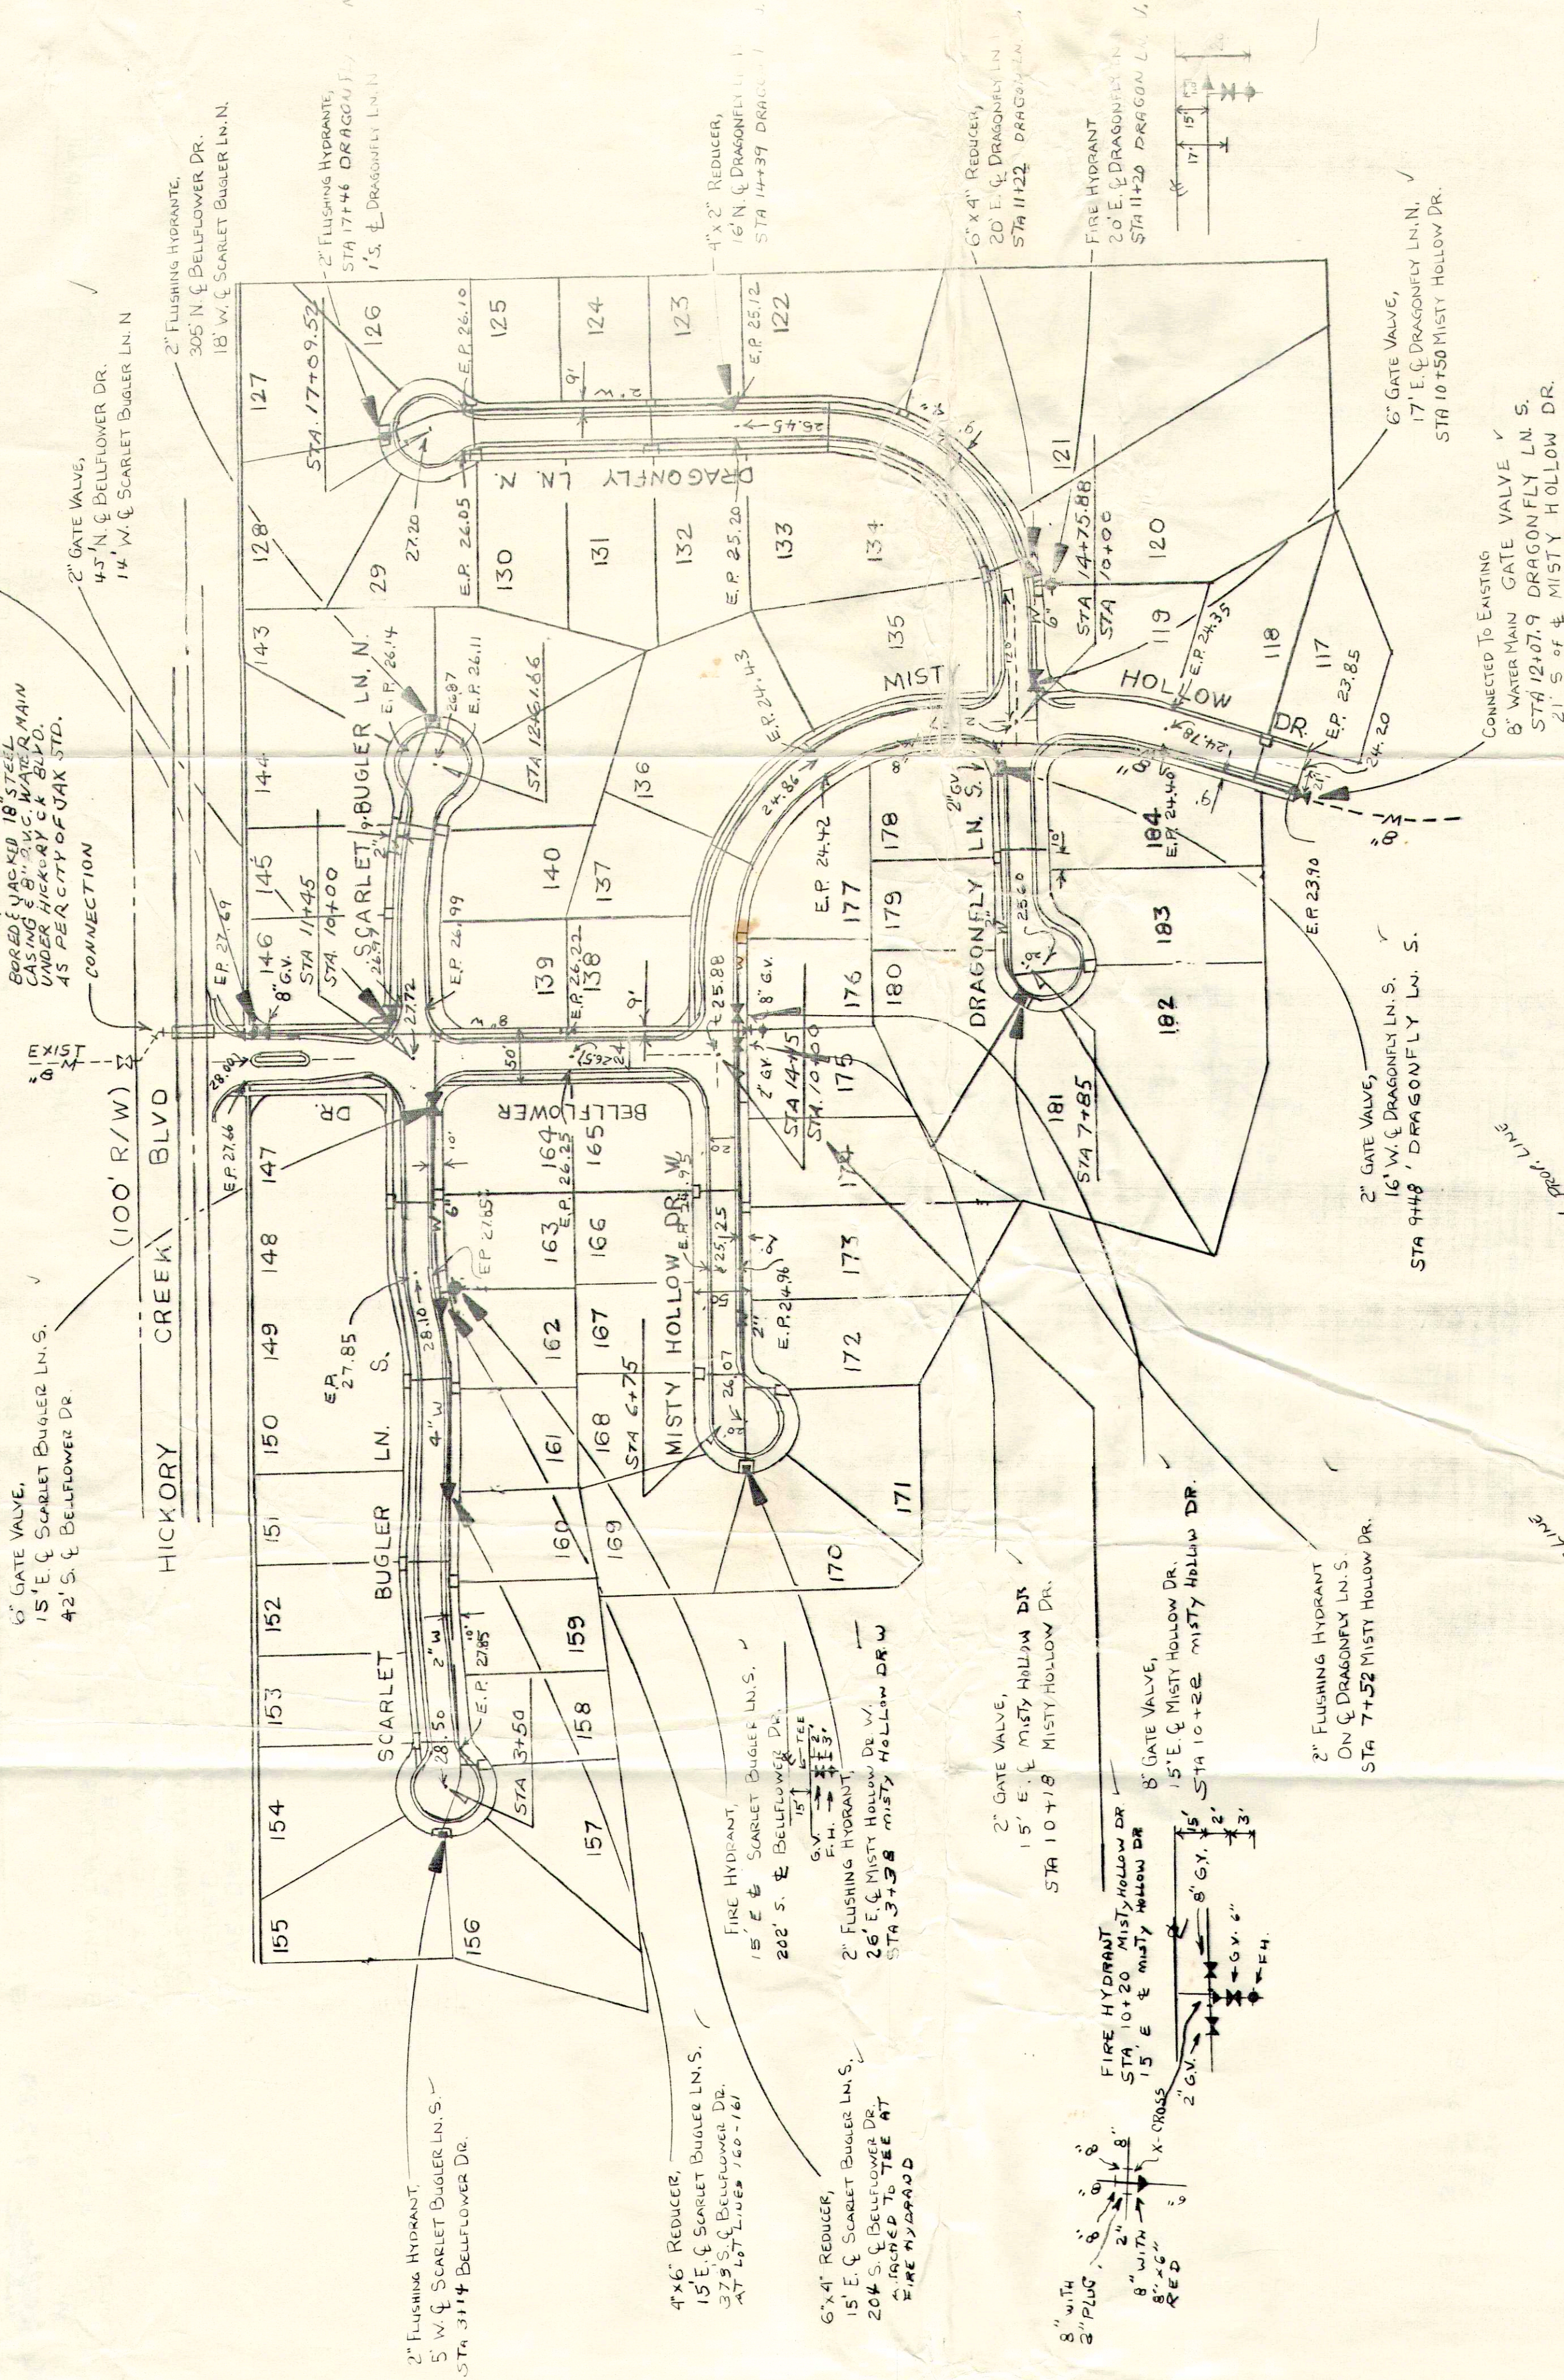


APPROVED
DATE 10-3-89
D.H.
DEPARTMENT OF PUBLIC UTILITIES
PLANS AND PROGRAMS BRANCH

CONTRACTOR STATEMENT
I CERTIFY THAT I HAVE THOROUGHLY STUDIED
THIS DRAWING. THIS DRAWING IS CORRECT
AND SHOWS EXACTLY WHAT WAS INSTALLED.

BY: Johnnie & Halcyne Kinnell & Makoffsky
WITH: A.J. JOHNS INC.
DATE: 9-7-89

SURVEYOR STATEMENT
THIS IS TO CERTIFY THAT THE SURVEYOR HAS
REVIEWED THE DATA SUBMITTED BY THE CONTRACTOR
IN THE FIELD AND TO THE BEST OF HIS KNOWLEDGE
AND BELIEF THESE ASBUILT DRAWINGS ARE CORRECT.
BY: A.J. JOHNS
WITH: A.J. JOHNS INC.
DATE: 20 SEP 89
FLORIDA REGISTRATION NUMBER: 2757

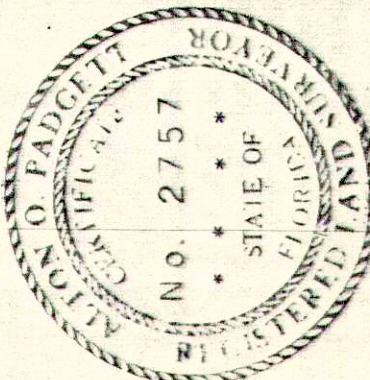

WATER
DRAINAGE
STREETS