


VICINITY MAP

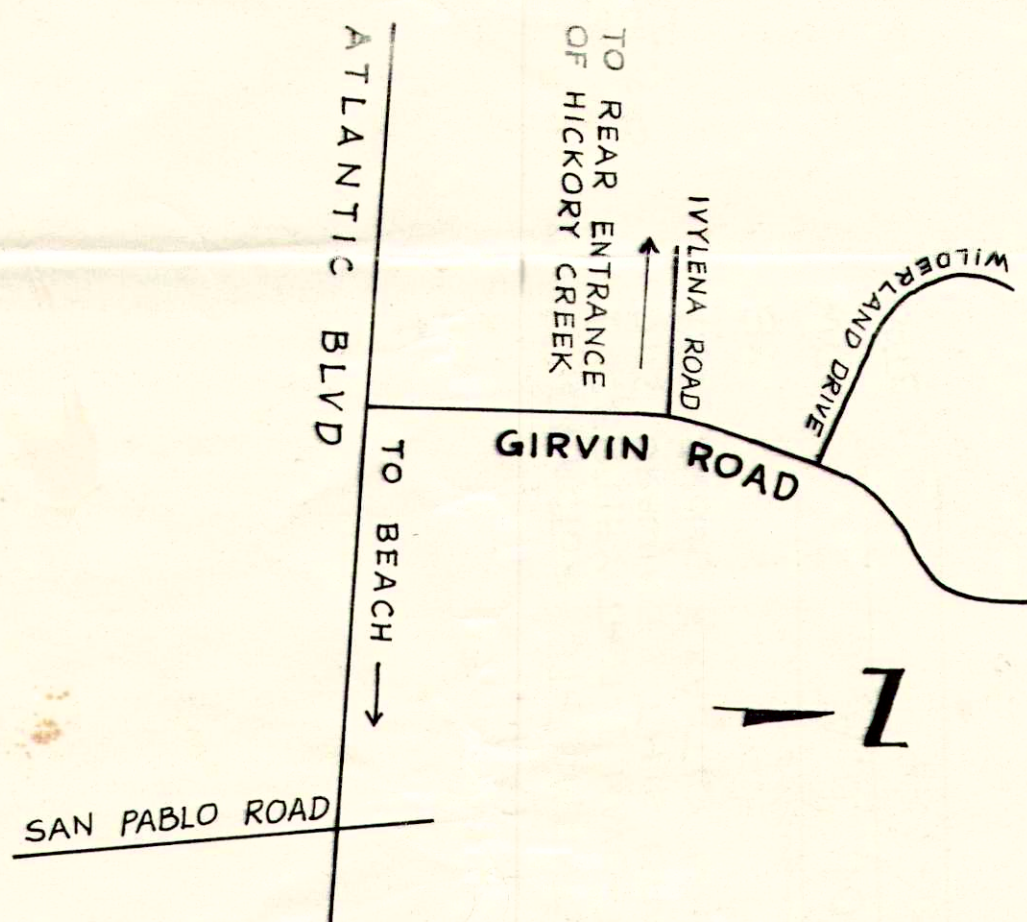

CONTRACTOR STATEMENT
I CERTIFY THAT I HAVE THOROUGHLY STUDIED
THIS DRAWING. THIS DRAWING IS CORRECT
AND SHOWS THE LOCATION OF THE
SEWER LINE WHICH WAS INSTALLED.
James E. McArthur 9-7-89
A. L. JOHNS INC
9-7-89

SURVEYORS STATEMENT
I HEREBY CERTIFY THAT THE
HORIZONTAL AND VERTICAL
LOCATIONS OF THE UTILITIES
WERE FIELD VERIFIED AND
REFLECT THE ACTUAL CONDITIONS
SHOWN ON THIS AS-BUILT
BY: A. L. JOHNS 20 Sept 89
WITH: A. L. JOHNS INC.
DATE: 20 Sept 89
FLORIDA REGISTRATION NO. 2757

NOTE: ALL SEWER SERVICES ARE
30" TO 60" DEEP AT PROPERTY
LINE UNLESS NOTED OTHERWISE

APPROVED
DATE 10-5-89
P. H.
DEPARTMENT OF PUBLIC UTILITIES
PLANS AND PROGRAMS BRANCH

HICKORY CREEK PHASE I

