

FOR CONTINUATION SEE HICKORY CK BLVD.
(DWG. 3 OF 9, ST. JOHNS ENVS.)

PHASE III PHASE IV

PHASE I

PHASE II

BLVD

CREEK

HICKORY

STA. 10+00





100' R/W

SCALE: 1"=100'

N 00° 00' 00" E

2715.39'

2630.15'

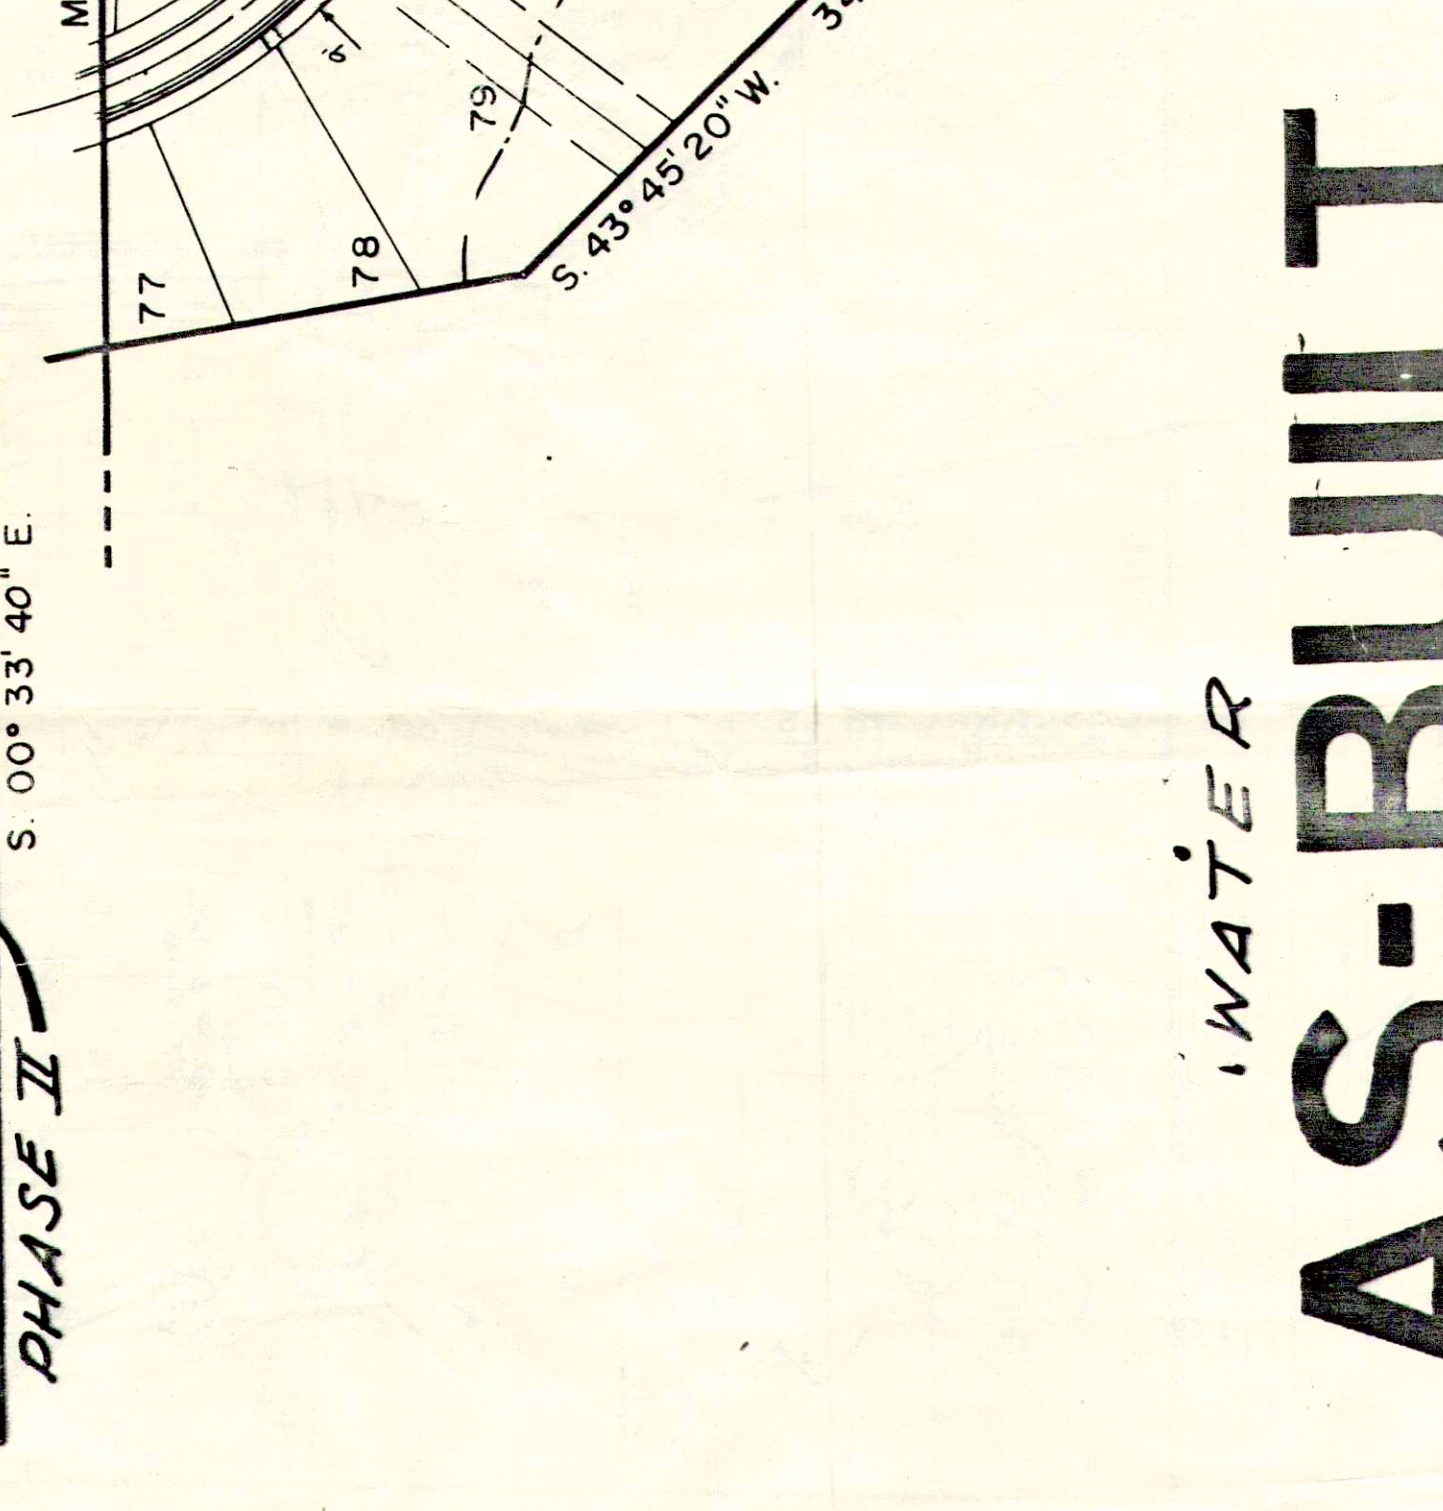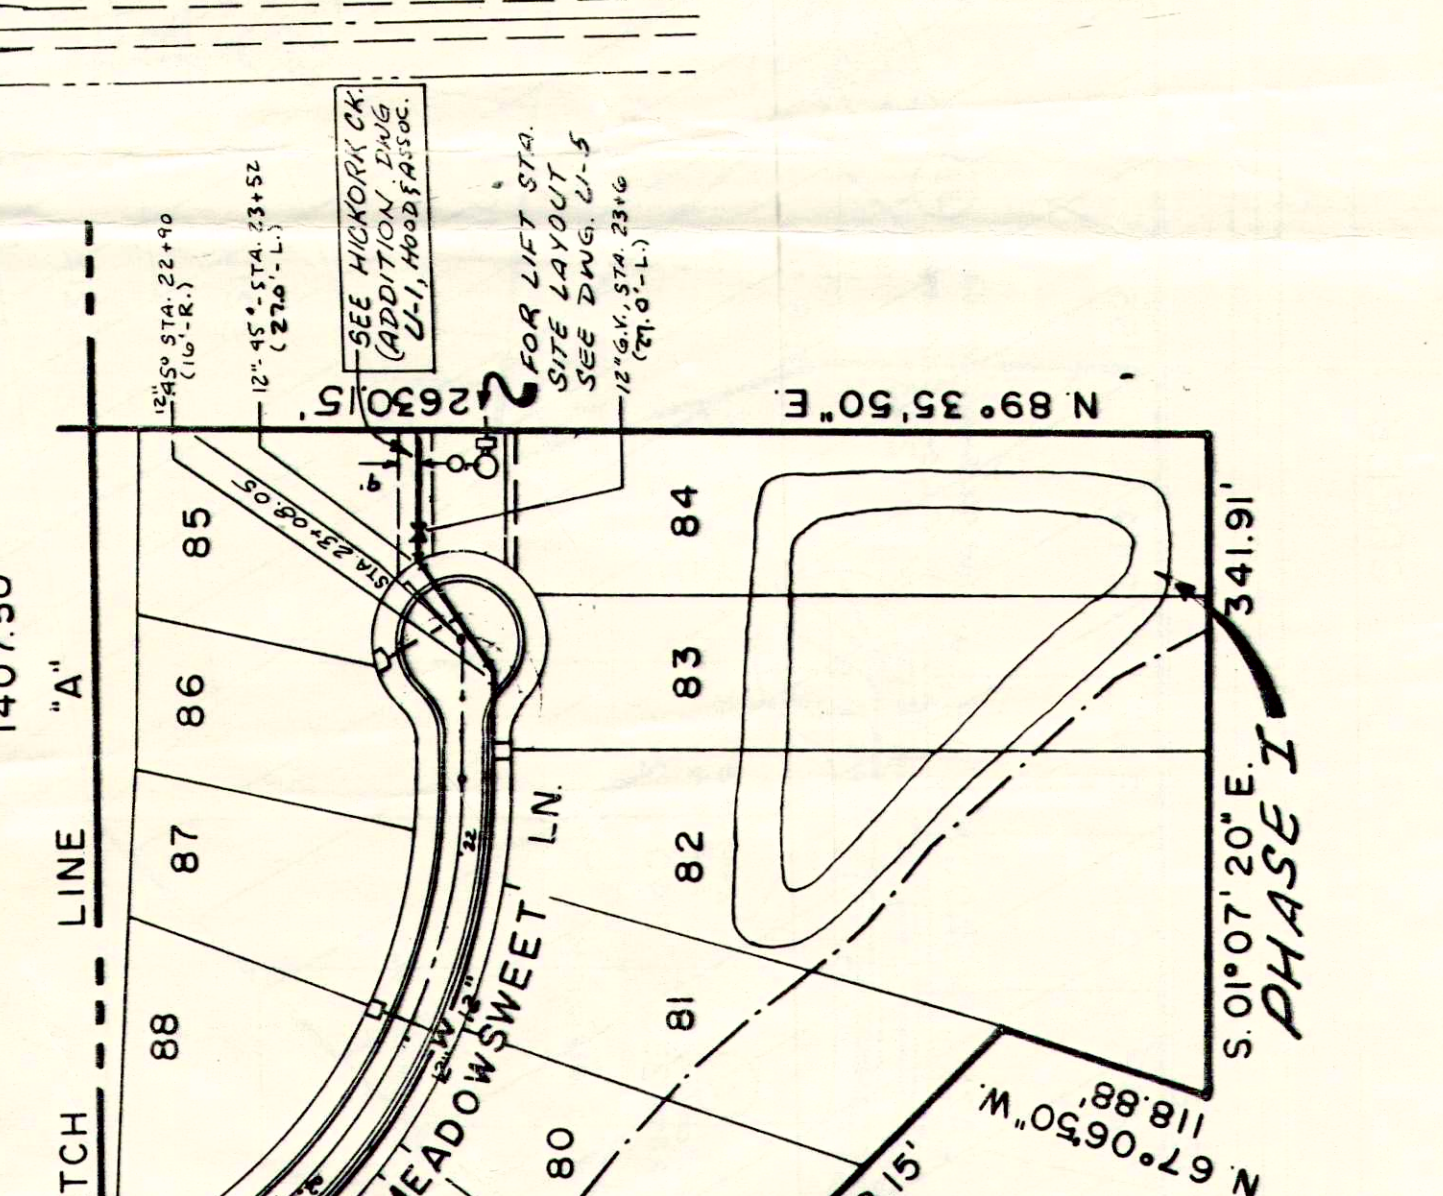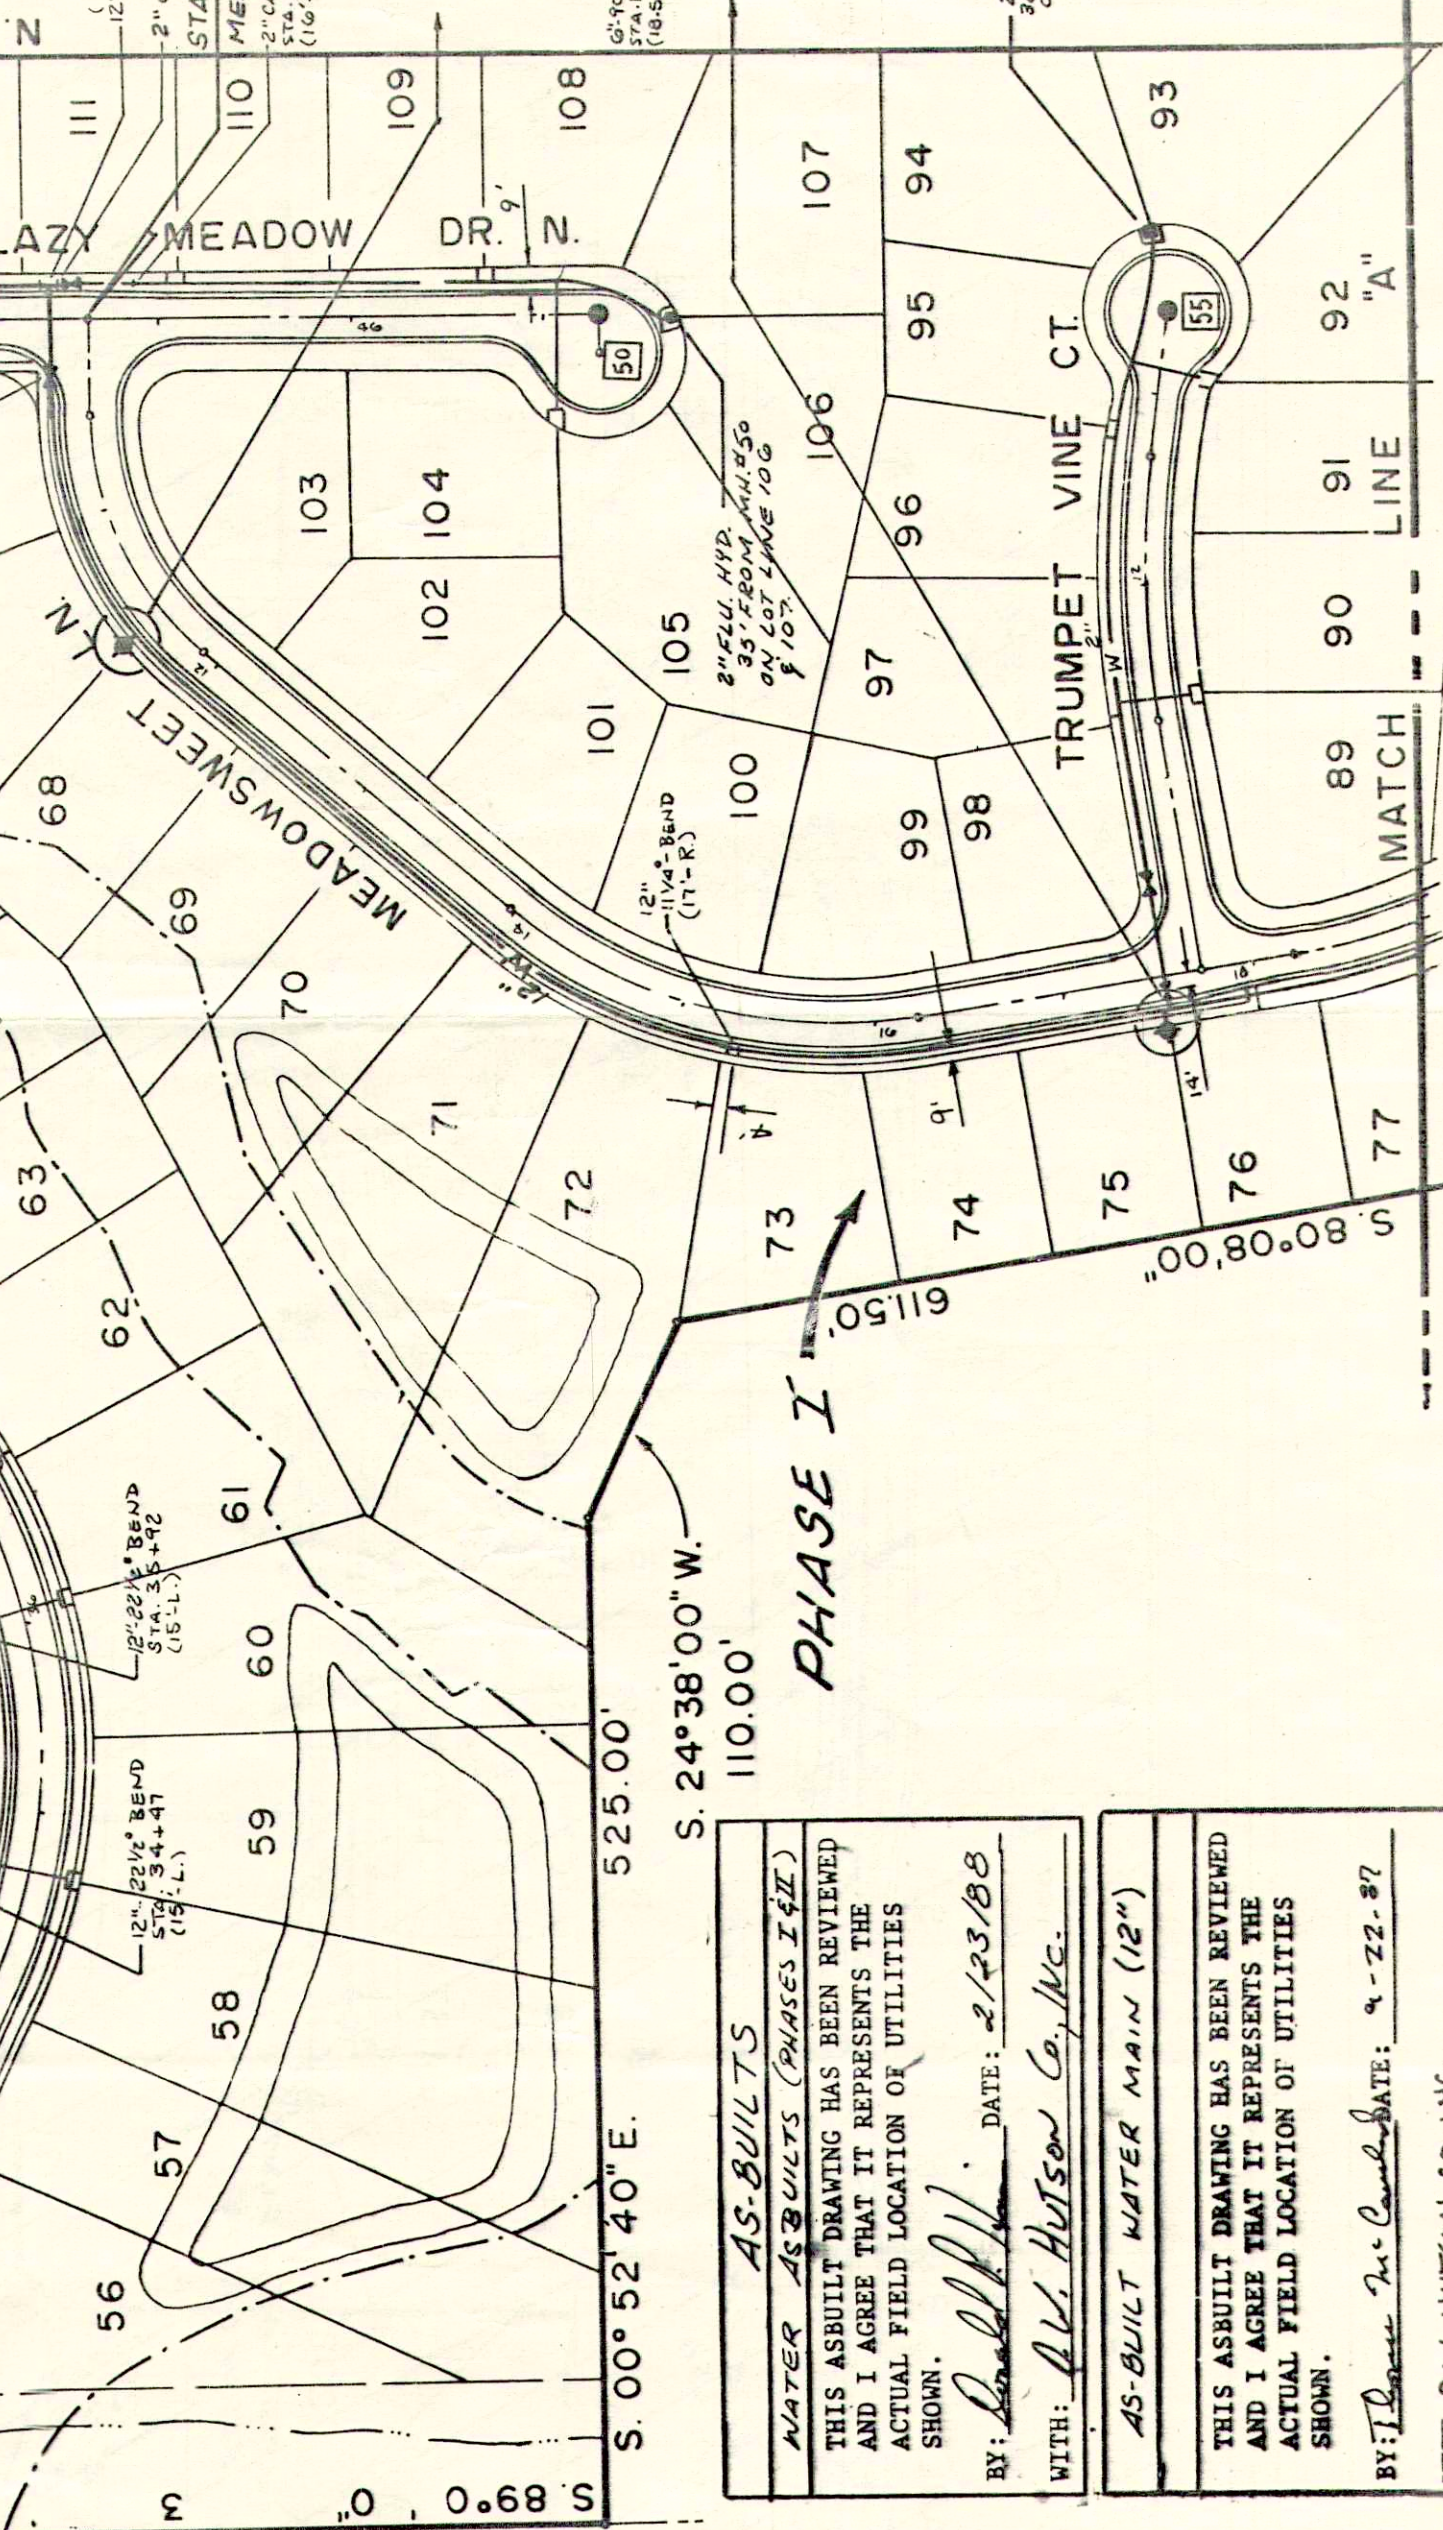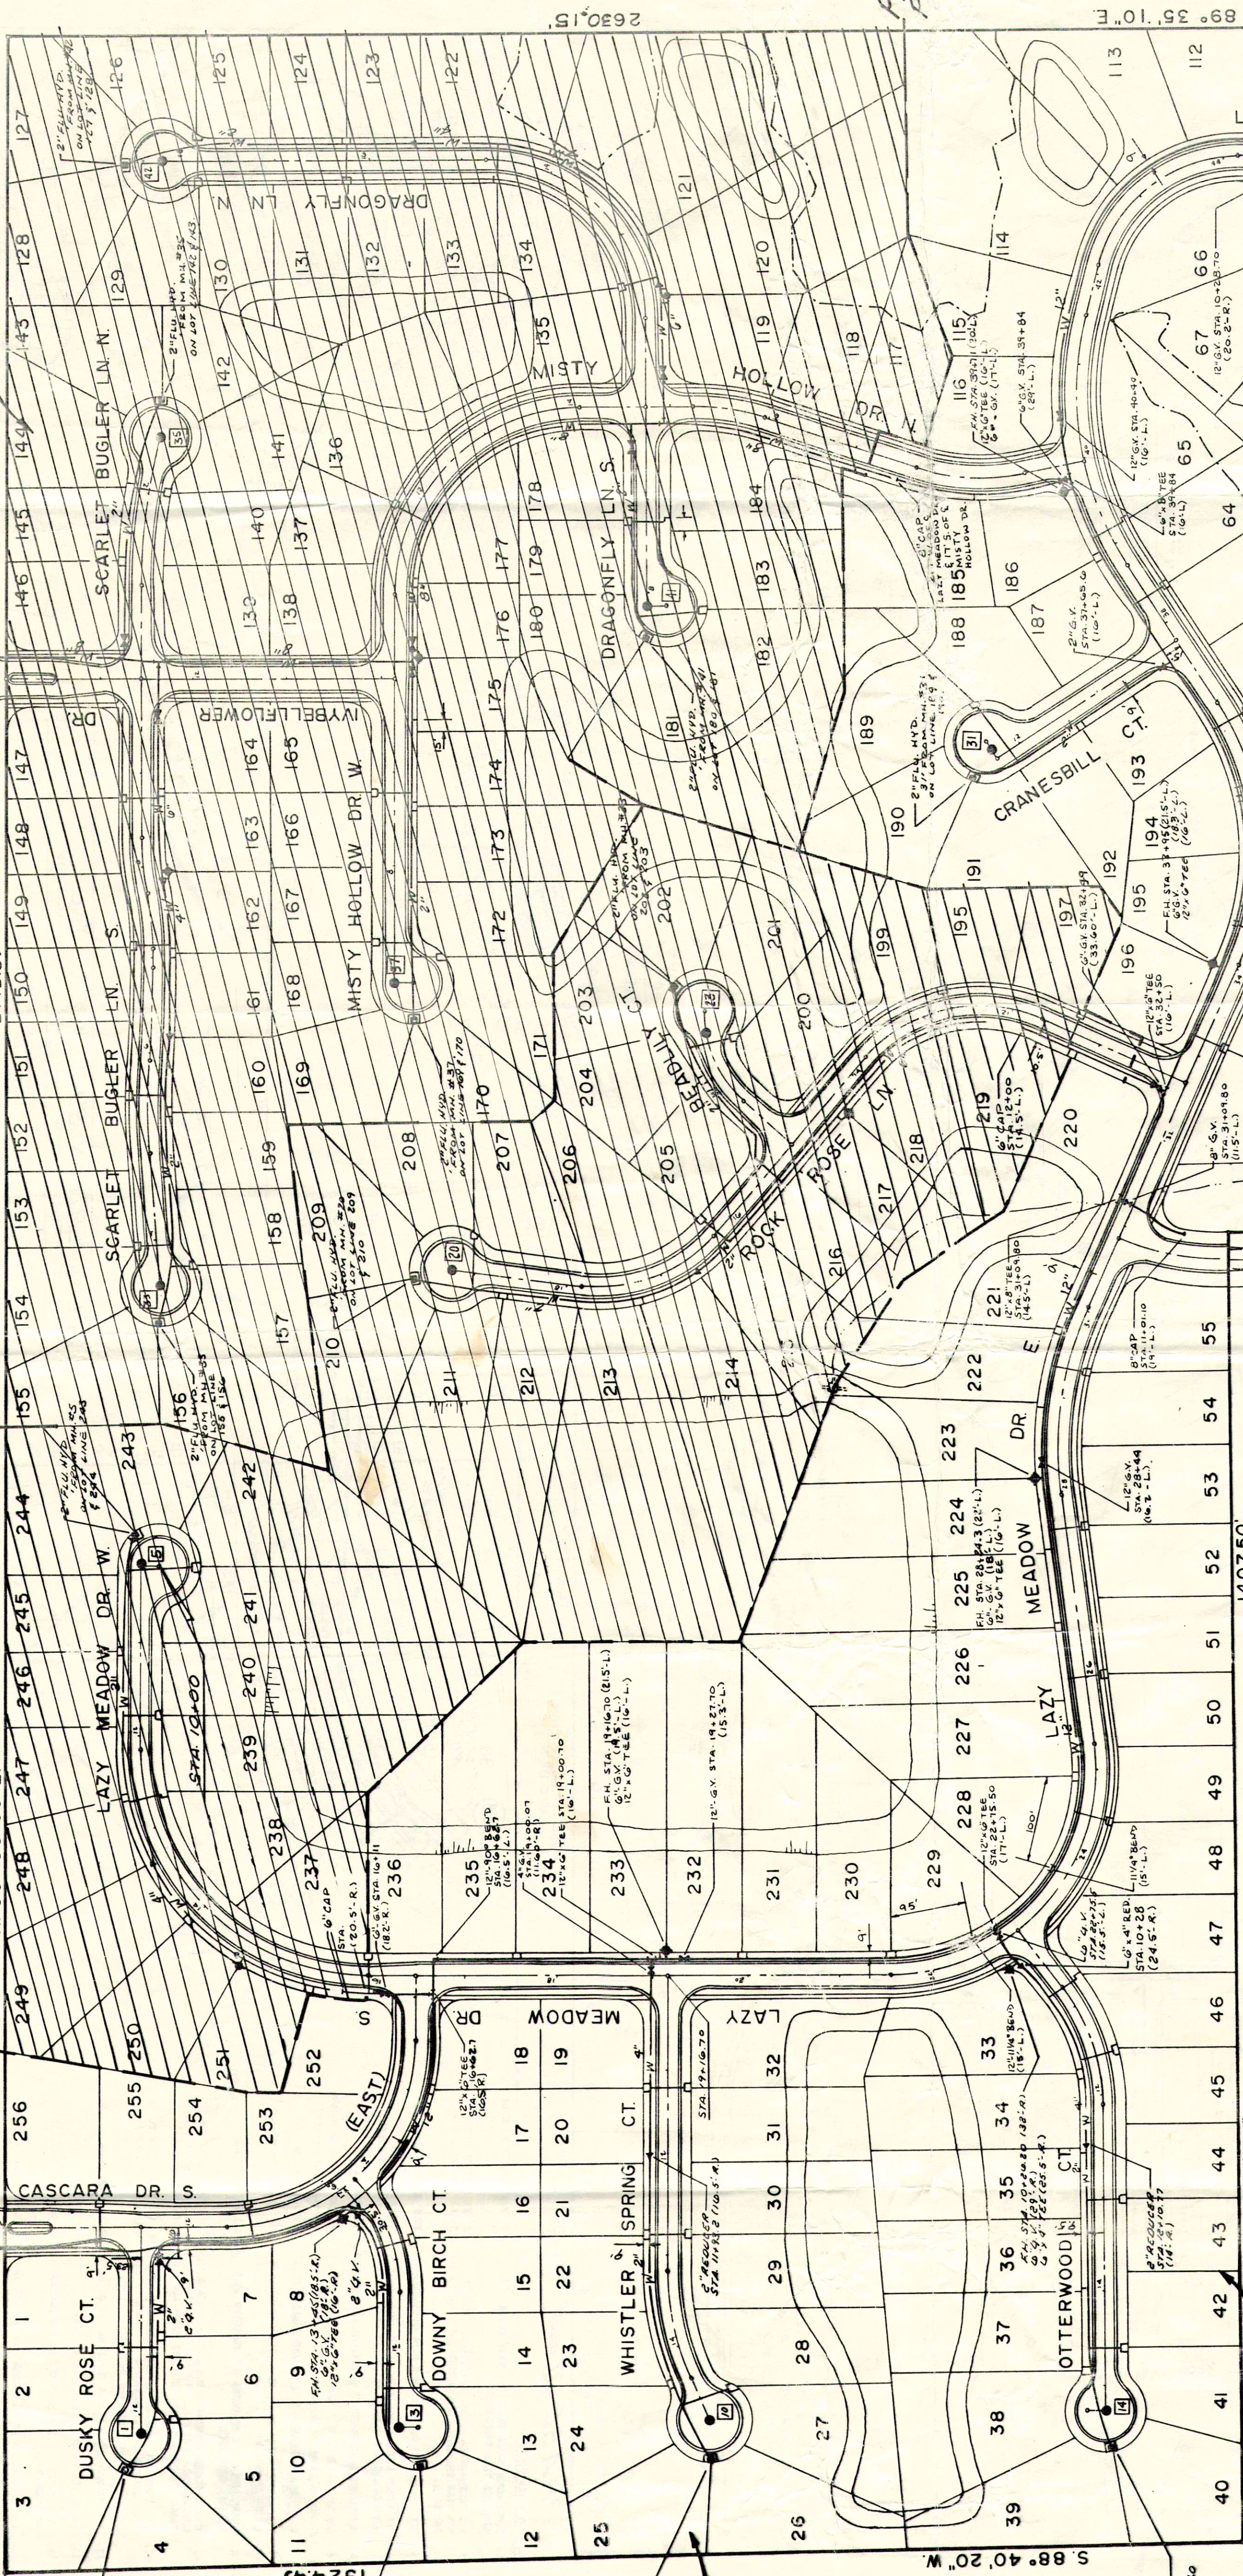

ALL AMERICAN SURVEYORS, INC.
LAND SURVEYORS - 4220 HOOD ROAD - JACKSONVILLE, FLORIDA, 32217 - 904/268-4195

I HEREBY CERTIFY THAT THE ABOVE LANDS WERE SURVEYED UNDER MY RESPONSIBLE SUPERVISION AND DIRECTION, THAT THERE ARE NO ENCROACHMENTS EXCEPT AS SHOWN AND THAT THE SURVEY SHOWN HEREON MEETS THE MINIMUM TECHNICAL STANDARDS SET FORTH BY THE FLORIDA BOARD OF LAND SURVEYORS PURSUANT TO SECTION 472.027, FLORIDA, STATUTES

JAMES D. HARRISON, JR., P. L. S. No. 2647
LARRY S. EDDY, P. L. S. No. 4144

DATE 3-16-88

ALL AMERICAN SURVEYORS, INC.