DESIGN

CONTROL STRUCTURE DATA

STRUCT NO.	TYPE OF STRUCT	ELEVATIONS A	B	C	D		X	Y
S-5	"C" INLET	24.00	23.55	22.32	21.80		0.60	0.167
S-20		24.00	23.31	21.60	21.25		0.50	0.27
S-26		22.00	21.34	20.54	19.50		1.50	0.167
S-30		21.60	20.61	19.00	18.00		0.50	0.167
S-33		24.20	22.71	22.37	21.00		2.00	0.167
S-37		21.20	19.59	18.81	18.00		0.75	0.167
S-43	"C" INLET	19.00	17.09	16.10	15.00		1.00	0.167

AS-BUILT

CONTROL STRUCTURE DATA

STRUCT NO.	TYPE OF STRUCT	ELEVATION A	B	C	D		X	Y
S-5	"C" INLET	23.90	23.40	22.18	21.65		0.62	0.18
S-20		24.10	22.38	21.68	21.33		0.52	0.28
S-26		22.61	21.81	20.45	19.42		1.51	0.18
S-30		21.53	20.97	19.35	18.35		0.50	0.167
S-33		24.21	22.69	22.35	21.49		2.00	0.20
S-37		21.09	19.49	18.69	17.87		0.75	0.18
S-43	"C" INLET	19.03	17.13	16.13	15.03		1.02	0.18

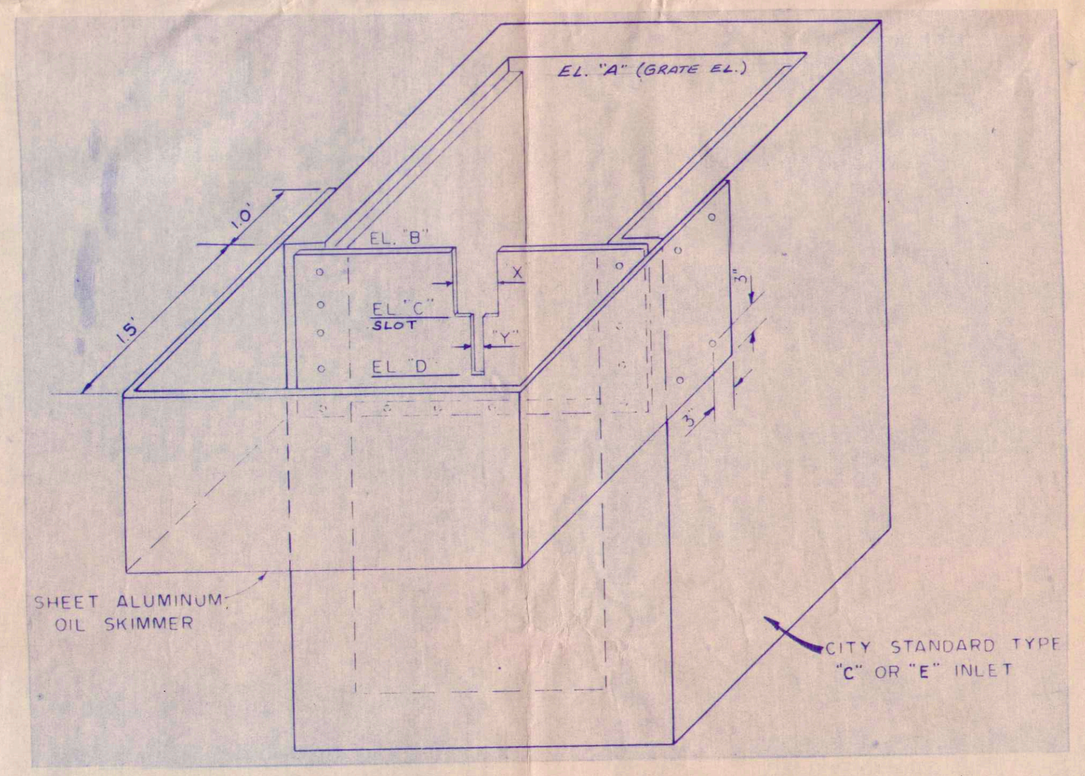

ALL AMERICAN SURVEYORS, INC.
LAND SURVEYORS - 4220 HOOD ROAD - JACKSONVILLE, FLORIDA, 32217 - 904/268-4155

I HEREBY CERTIFY THAT THE ABOVE LANDS WERE SURVEYED UNDER MY RESPONSIBLE SUPERVISION AND DIRECTION, THAT THERE ARE NO ENCROACHMENTS EXCEPT AS SHOWN AND THAT THE SURVEY SHOWN HEREON MEETS THE MINIMUM TECHNICAL STANDARDS SET FORTH BY THE FLORIDA BOARD OF LAND SURVEYORS PURSUANT TO SECTION 472.027. FLORIDA, STATUTES

JAMES O. HARRISON, JR., P. L. S. No. 2647
LARRY G. EDDY, P. L. S. No. 4144

SCALE _____

DATE 5-3-87 REGISTERED SURVEYOR, STATE OF FLORIDA

ALL AMERICAN SURVEYORS, INC.

AS-BUILT

AS-BUILT

THIS ASBUILT DRAWING HAS BEEN REVIEWED AND I AGREE THAT IT REPRESENTS THE ACTUAL FIELD LOCATION OF UTILITIES SHOWN.

BY: [signature] DATE: 4-25-88

WITH: D.W. HATTON CO., INC.

REVISIONS

DATE
SCALE
DES.
DWN.
CHK.
APP.

William Hood & Associates, Inc.
CONSULTING ENGINEERS
JACKSONVILLE, FLORIDA

DRAINAGE DETAILS
HICKORY CREEK
WEIR DESIGN

FILE NO.

SHEET 2 of 2
G-6

HICKORY CREEK #182 PGA 212/88

DENSE PRINT 88472